

ROLL CALL VOTING:		
	YES	NO
Mayor Wendy Pray (tie only)	[]	[]
Council Member Dorel Kynaston	[X]	[]
Council Member Paul MacArthur	[X]	[]
Council Member Kari Malkovich	[X]	[]
Council Member Bob Ottley	[X]	[]
Council Member David Pratt	[X]	[]

I move that this Ordinance be adopted.

Council Member

DAVID PRATT

I second the foregoing motion:



Council Member

ORDINANCE NO. 2021- 25

AN ORDINANCE ADOPTING AN ALTERNATIVE DEVELOPMENT AND CONSTRUCTION STANDARD FOR SIDEWALK, WALKING PATHS, BIKE PATHS and TRAILS

WHEREAS the Planning Commission of the City of Woodland Hills has recommended to the City Council that an alternative design for sidewalks, walking paths, bike paths and trails be included in the City of Woodland Hills Development and Construction Standards; and,


WHEREAS the Planning Commission held a public hearing on September 15, 2021, where public comment was heard on a proposed alternative design for sidewalks, walking paths, bike paths and trails to be included in the City of Woodland Hills Development and Construction Standards; and,


WHEREAS the City Council held a public hearing on October 26, 2021.

NOW THEREFORE, be it Ordained by the City Council of the City of Woodland Hills; Exhibit A be included in the City of Woodland Hills Development and Construction Standards as an alternative design for sidewalks, walking paths, bike paths and trails

Passed by the City Council of Woodland Hills this 26th day of October 2021.

Attest:

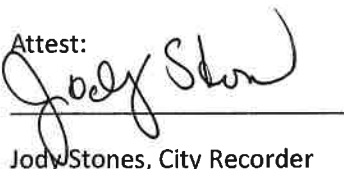
Jody Stones, City Recorder

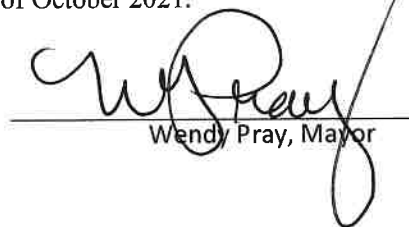
Wendy Pray, Mayor

CERTIFICATE OF POSTING ORDINANCE

For the City of Woodland Hills

I, the duly appointed and acting Recorder for the City of Woodland Hills, hereby certify that.

copies of the foregoing Ordinance No. 2021- ~~25~~ were posted at three public places within

the municipality this 27th day of October which public places are:


1. City Information Bulletin Board, 200 S. Woodland Hills Drive
2. Woodland Hills City Center, 690 S. Woodland Hills Drive
3. Woodland Hills Web Site, www.woodlandhills-ut.gov

Dated this 27th day of October 2021.



Jody Stones, City Recorder

EXHIBIT A

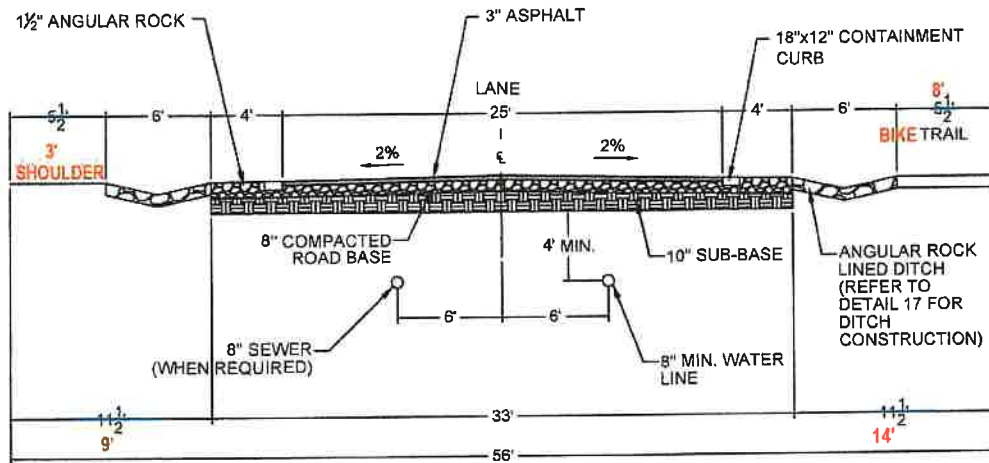

NOTE: WATER MAINS TO BE LOCATED ON THE NORTH & EAST SIDES OF THE STREETS.

8-10-2021

STANDARD #

2

DRAWN BY

BDS

CHECKED BY:

BT

SCALE:

N.T.S.

DATE:


12/11/2019

CONSTRUCTION STANDARDS

56' COLLECTOR STREET CROSS SECTION WITHOUT CURB

880 S. Woodland Hills Dr.
Woodland Hills, UT 84659
Phone: 801-423-1562
Fax: 801-423-3501
www.woodlandhills.ut.gov



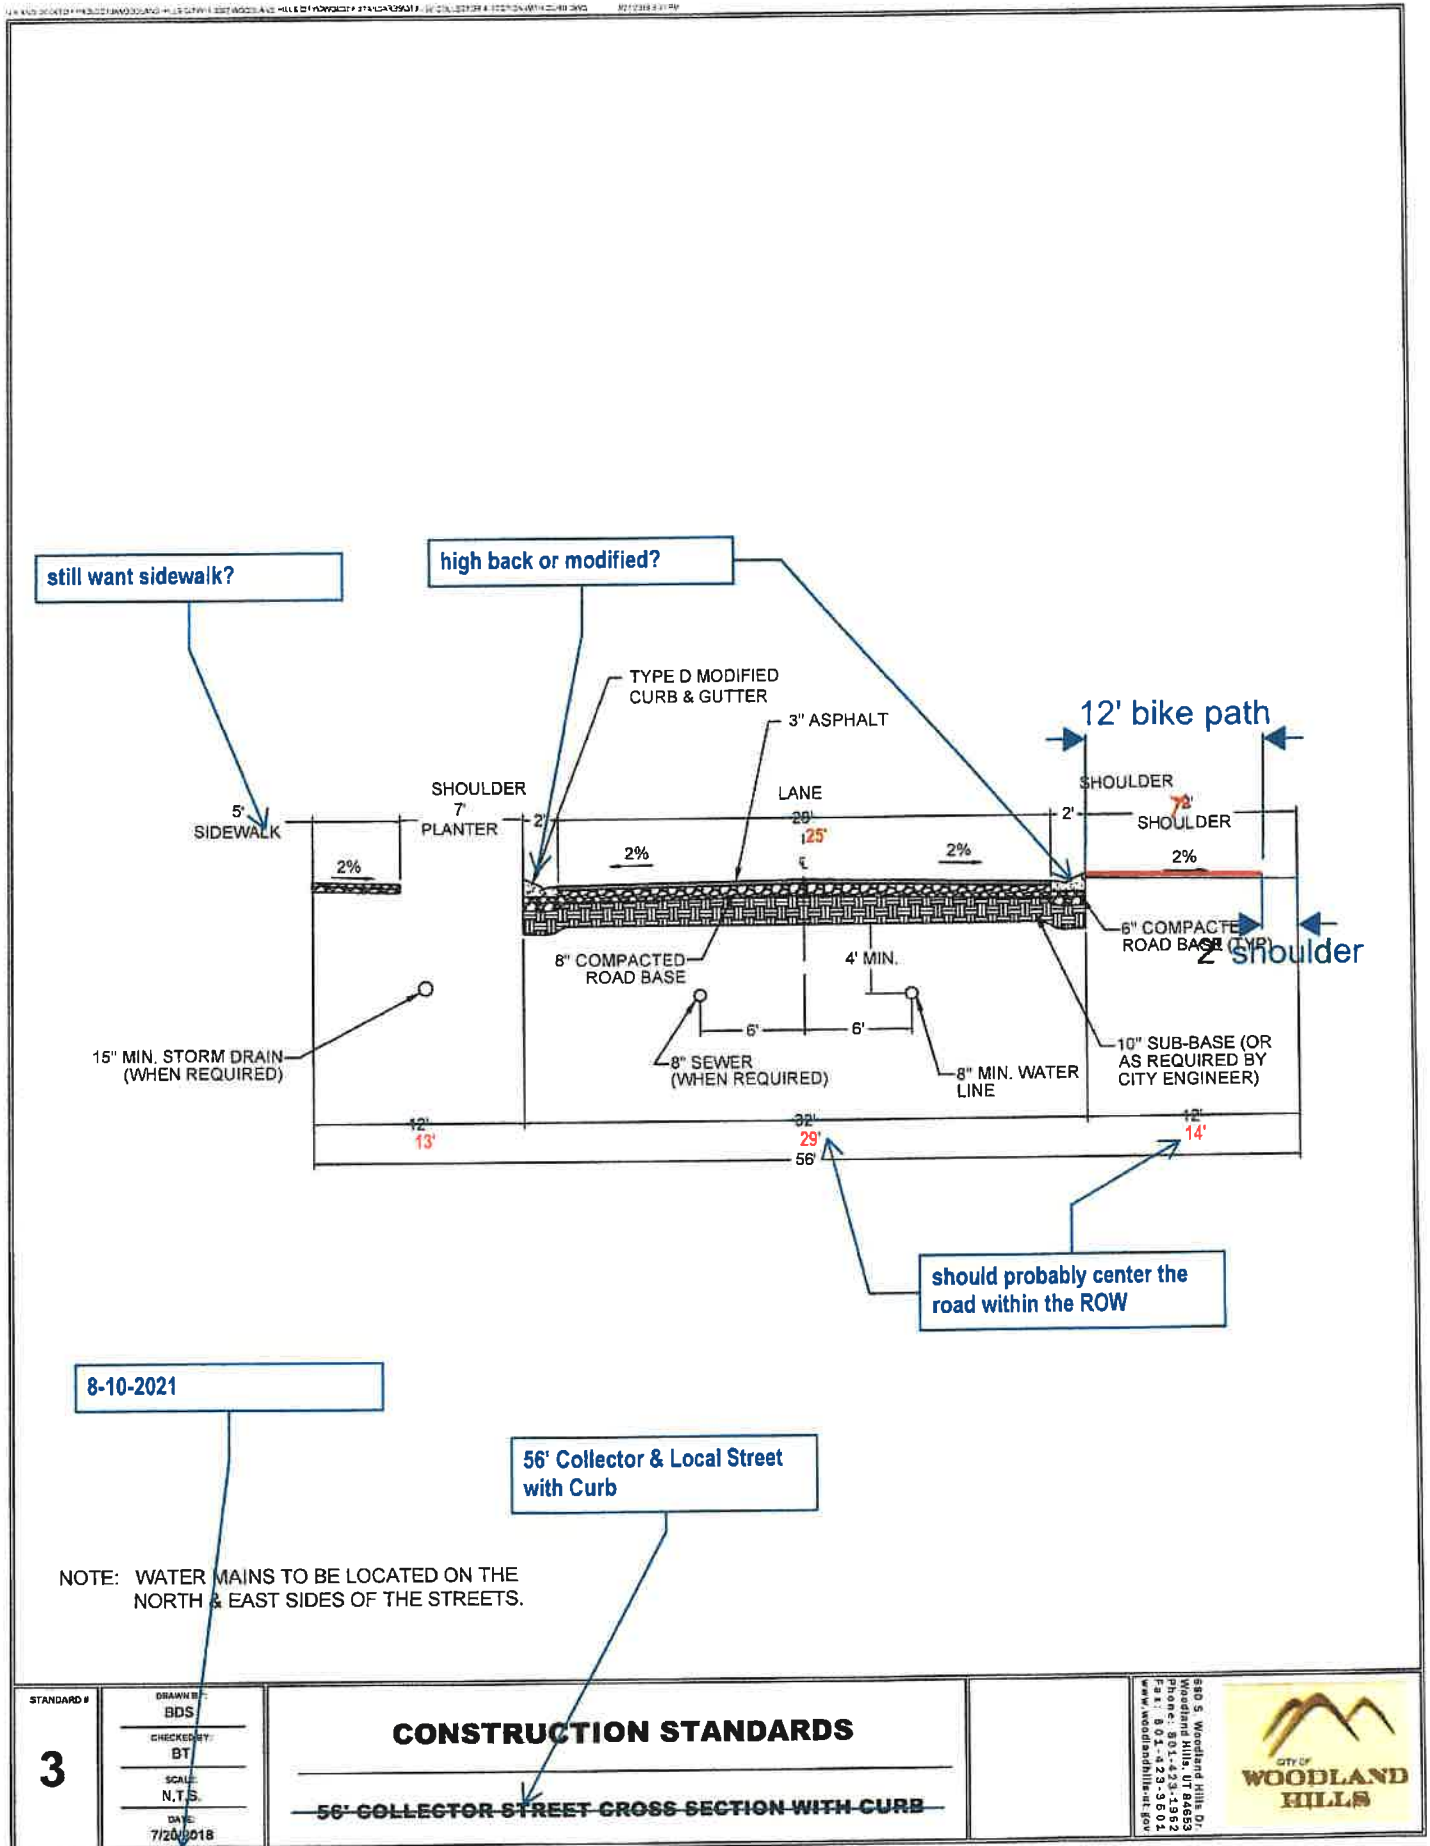

STANDARD #

3

DRAWN BY:
BDS

CHECKED BY:
BT

SCALE:
N.T.S.

DATE:
7/20/2018

CONSTRUCTION STANDARDS

~~56' COLLECTOR STREET CROSS SECTION WITH CURB~~

880 S. Woodland Hills Dr.
Woodland Hills, UT 84653
Phone: 801-423-1352
Fax: 801-423-3501
www.woodlandhills-ut.gov

